

TYPICAL ELEVATION NOTES:

- 1 VINYL WINDOWS
- 1 DECORATIVE TILE ACCENTS
- 2
- 4
- 3
- 5
- 6
- SILL TRIM AT WINDOWS
-SEE DETAILS
- PAINTED METAL RAILINGS
W/18" CURB BELOW AT 1ST FLR
CENTER STREET
- PAINTED METAL GARAGE VENTS
-TO MATCH RAILINGS
- EXTERIOR LIGHT FIXTURE
- SEE ELECTRICAL DRAWINGS
- LINE OF GARAGE BELOW

1 SOUTH ELEVATION
3/16"=1'-0"




2 EAST ELEVATION
SCALE : 3/16"=1'-0"

GENERAL NOTES:

KEY NOTES:

- 1 CONCRETE S-TILE ROOFING:
Eagle Capistrano
Color: #3645 Sunrise Blend
- 2 STUCCO TRIM:
La Habra or equivalent, Smooth finish, painted.
Color: Benjamin Moore, #2144-60 "Cloud Nine"
- 3 STUCCO SIDING:
La Habra or equivalent, 7/8" thick, 3-Coat, "Santa Barbara" finish, painted.
Color: Benjamin Moore, #HC-81 "Manchester Tan"
- 4 STUCCO SIDING:
La Habra or equivalent, 7/8" thick, 3-Coat, Smooth finish, painted.
Color: Benjamin Moore, #2148-40 "Light Khaki"
- 5 STUCCO SIDING:
La Habra or equivalent, 7/8" thick, 3-Coat, "Santa Barbara" finish, painted.
Color: Benjamin Moore, #2148-30 "Military Tan"
- 6 STUCCO SIDING:
La Habra or equivalent, 7/8" thick, 3-Coat, Smooth finish, painted.
Color: Benjamin Moore, #2148-10 "Foot Hills"
- 7 WOOD BEAMS:
Architectural Grade Cedar or Douglas Fir
Finish: Olympic Semi-transparent
Color: Natural
- 8 PAINTED FIBER BOARD TRIM
-SEE VARIOUS DETAILS ON SHEET A8.5
-COLOR: TBD
- 9 METAL RAILINGS:
-SEE DETAILS 8 & 13 ON SHEET A8.3
- 10 SOLAR HOT WATER PANELS
-SEE PLUMBING DRAWINGS
- 11 PAINTED METAL GUTTERS & DOWNSPOUTS
-SEE DETAIL 20/A8.3
-COLOR: TBD
- 12 2'X3' VELUX SKYLIGHT
- 13 SOLATUBE 160 Dse
- 14 PAINTED LOUVRED SCREEN/VENT:
-COLOR: TBD

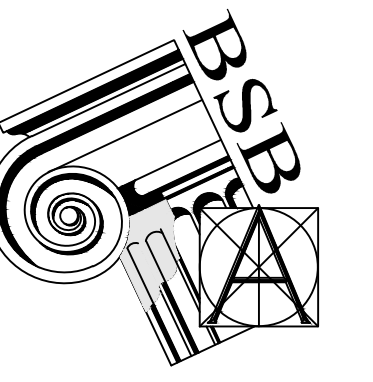

BARRY SWENSON BUILDER
A DIVISION OF GREEN VALLEY CORP.
777 North First Street
Fifth Floor
San Jose, Ca 95112
tel: (408) 287-0246
fax: (408) 996-1737

Consultant:


Key Plan

Revisions:

1 21 DECEMBER 2012
PLAN CHECK RESPONSE-1


COPYRIGHT © 2012
BARRY SWENSON BUILDER

WALNUT AVENUE COHOUSING
WALNUT AVE. & CENTER ST.
SANTA CRUZ, CA.
EXTERIOR ELEVATIONS

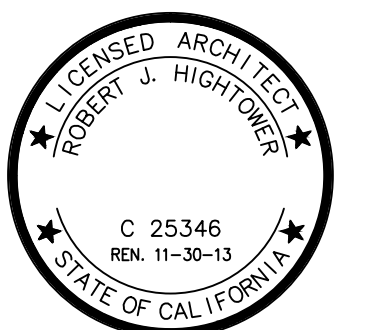

Date: OCTOBER 23, 2012
Scale: AS NOTED
Drawn by: AG, AP, TC, YM
Job #: 11-9149
Sheet:

A4.1

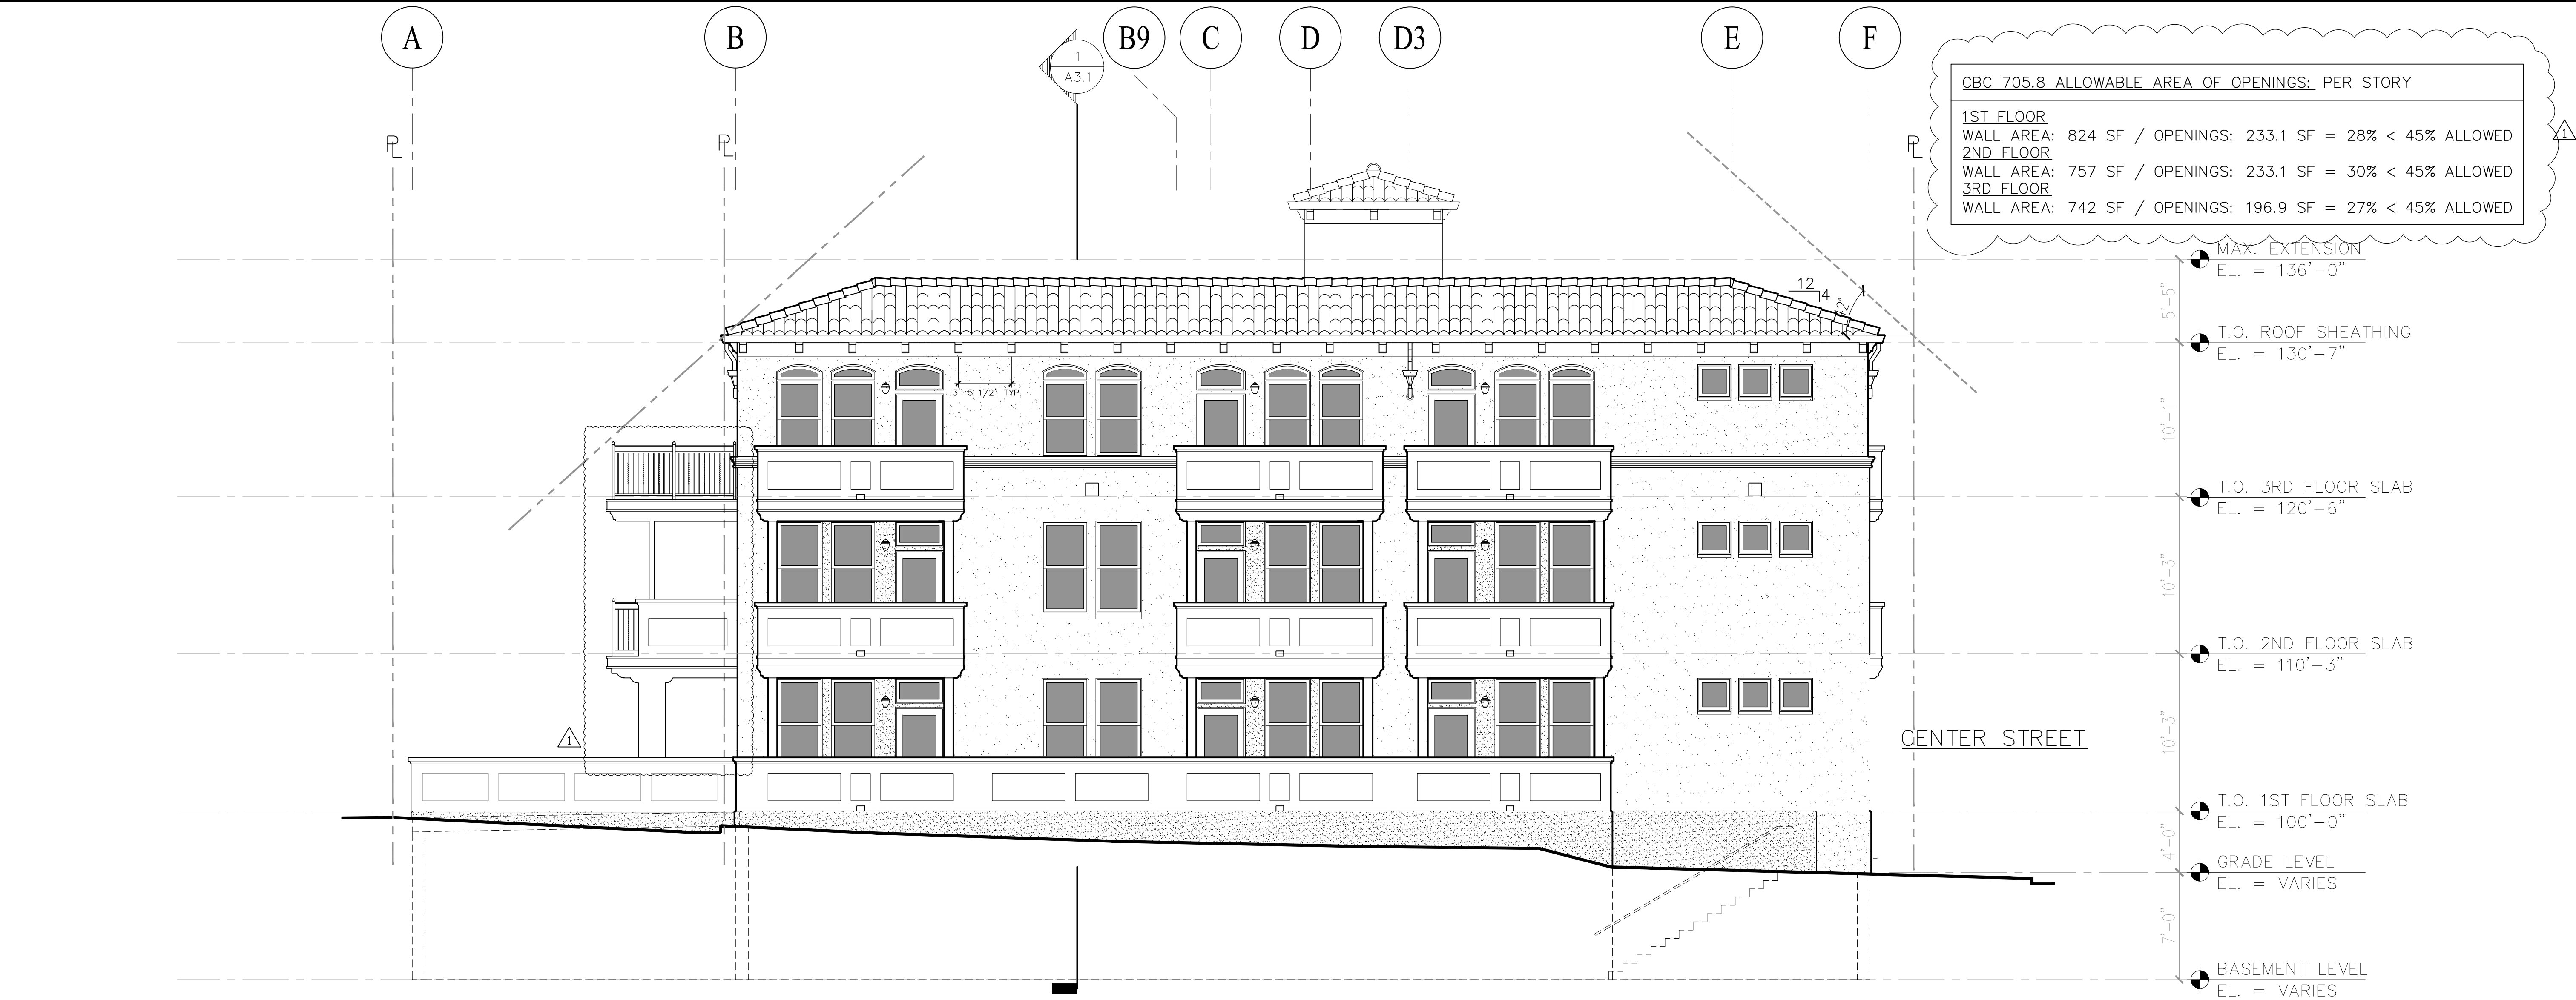

1 NORT ELEVATION
3/16"=1'-0"




2 WEST ELEVATION
SCALE : 3/16"=1'-0"

GENERAL NOTES:

KEY NOTES:

- 1 CONCRETE S-TILE ROOFING:
Eagle Capistrano
Color: #3645 Sunrise Blend
- 2 STUCCO TRIM:
La Habra or equivalent, Smooth finish, painted.
Color: Benjamin Moore, #2144-60 "Cloud Nine"
- 3 STUCCO SIDING:
La Habra or equivalent, 7/8" thick, 3-Coat, "Santa Barbara" finish, painted.
Color: Benjamin Moore, #HC-81 "Manchester Tan"
- 4 STUCCO SIDING:
La Habra or equivalent, 7/8" thick, 3-Coat, Smooth finish, painted.
Color: Benjamin Moore, #2148-40 "Light Khaki"
- 5 STUCCO SIDING:
La Habra or equivalent, 7/8" thick, 3-Coat, "Santa Barbara" finish, painted.
Color: Benjamin Moore, #2148-30 "Military Tan"
- 6 STUCCO SIDING:
La Habra or equivalent, 7/8" thick, 3-Coat, Smooth finish, painted.
Color: Benjamin Moore, #2148-10 "Foot Hills"
- 7 WOOD BEAMS:
Architectural Grade Cedar or Douglas Fir
Finish: Olympic Semi-transparent
Color: Natural
- 8 PAINTED FIBER BOARD TRIM
- SEE VARIOUS DETAILS ON SHEET A8.5
- COLOR: TBD
- 9 METAL RAILINGS:
- SEE DETAILS 8 & 13 ON SHEET A8.3
- 10 SOLAR HOT WATER PANELS
- SEE PLUMBING DRAWINGS
- 11 PAINTED METAL GUTTERS & DOWNSPOUTS
- SEE DETAIL 20/A8.3
- COLOR: TBD
- 12 2'X3' VELUX SKYLIGHT
- 13 SOLATUBE 160 Dse
- 14 PAINTED LOUVRED SCREEN/VENT:
- COLOR: TBD

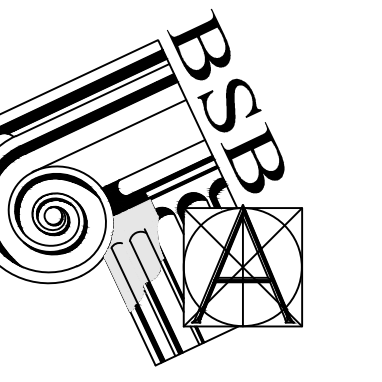

BARRY SWENSON BUILDER
A DIVISION OF GREEN VALLEY CORP.
777 North First Street
Fifth Floor
San Jose, Ca 95112
tel: (408) 287-0246
fax: (408) 998-1737

Consultant:

Key Plan


Revisions:

1 21 DECEMBER 2012
PLAN CHECK RESPONSE-1

COPYRIGHT © 2012
BARRY SWENSON BUILDER

WALNUT AVENUE COHOUSING
WALNUT AVE. & CENTER ST.
SANTA CRUZ, CA.

EXTERIOR ELEVATIONS

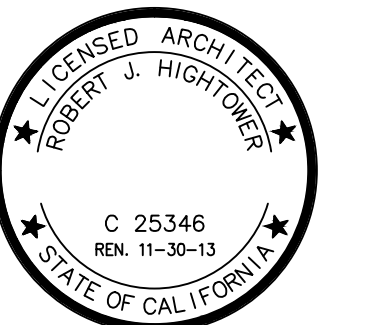

Date: OCTOBER 23, 2012
Scale: AS NOTED
Drawn by: AG, AP, TC, YM
Job #: 11-9149
Sheet:

A4.2